


- LEGEND**
- 8" SANITARY SEWER LINE, WITH SIZE
 - SANITARY MANHOLE
 - DIRECTION OF FLOW
 - 12" SANITARY SEWER LINE, WITH SIZE (EXISTING NOT TO BE RETAINED)

- ABBREVIATIONS**
- C CONCRETE
 - AC ASBESTOS CEMENT
 - VC VITRIFIED CLAY
 - CI CAST IRON

ELEVATIONS SHOWN HEREON THIS SHEET, THUS 23.52 (UNDERLINED) REPRESENT ELEVATIONS TAKEN FROM MAP NO DM73, DELAWARE ORDNANCE DEPOT, OFFICE OF THE POST ENGINEER.

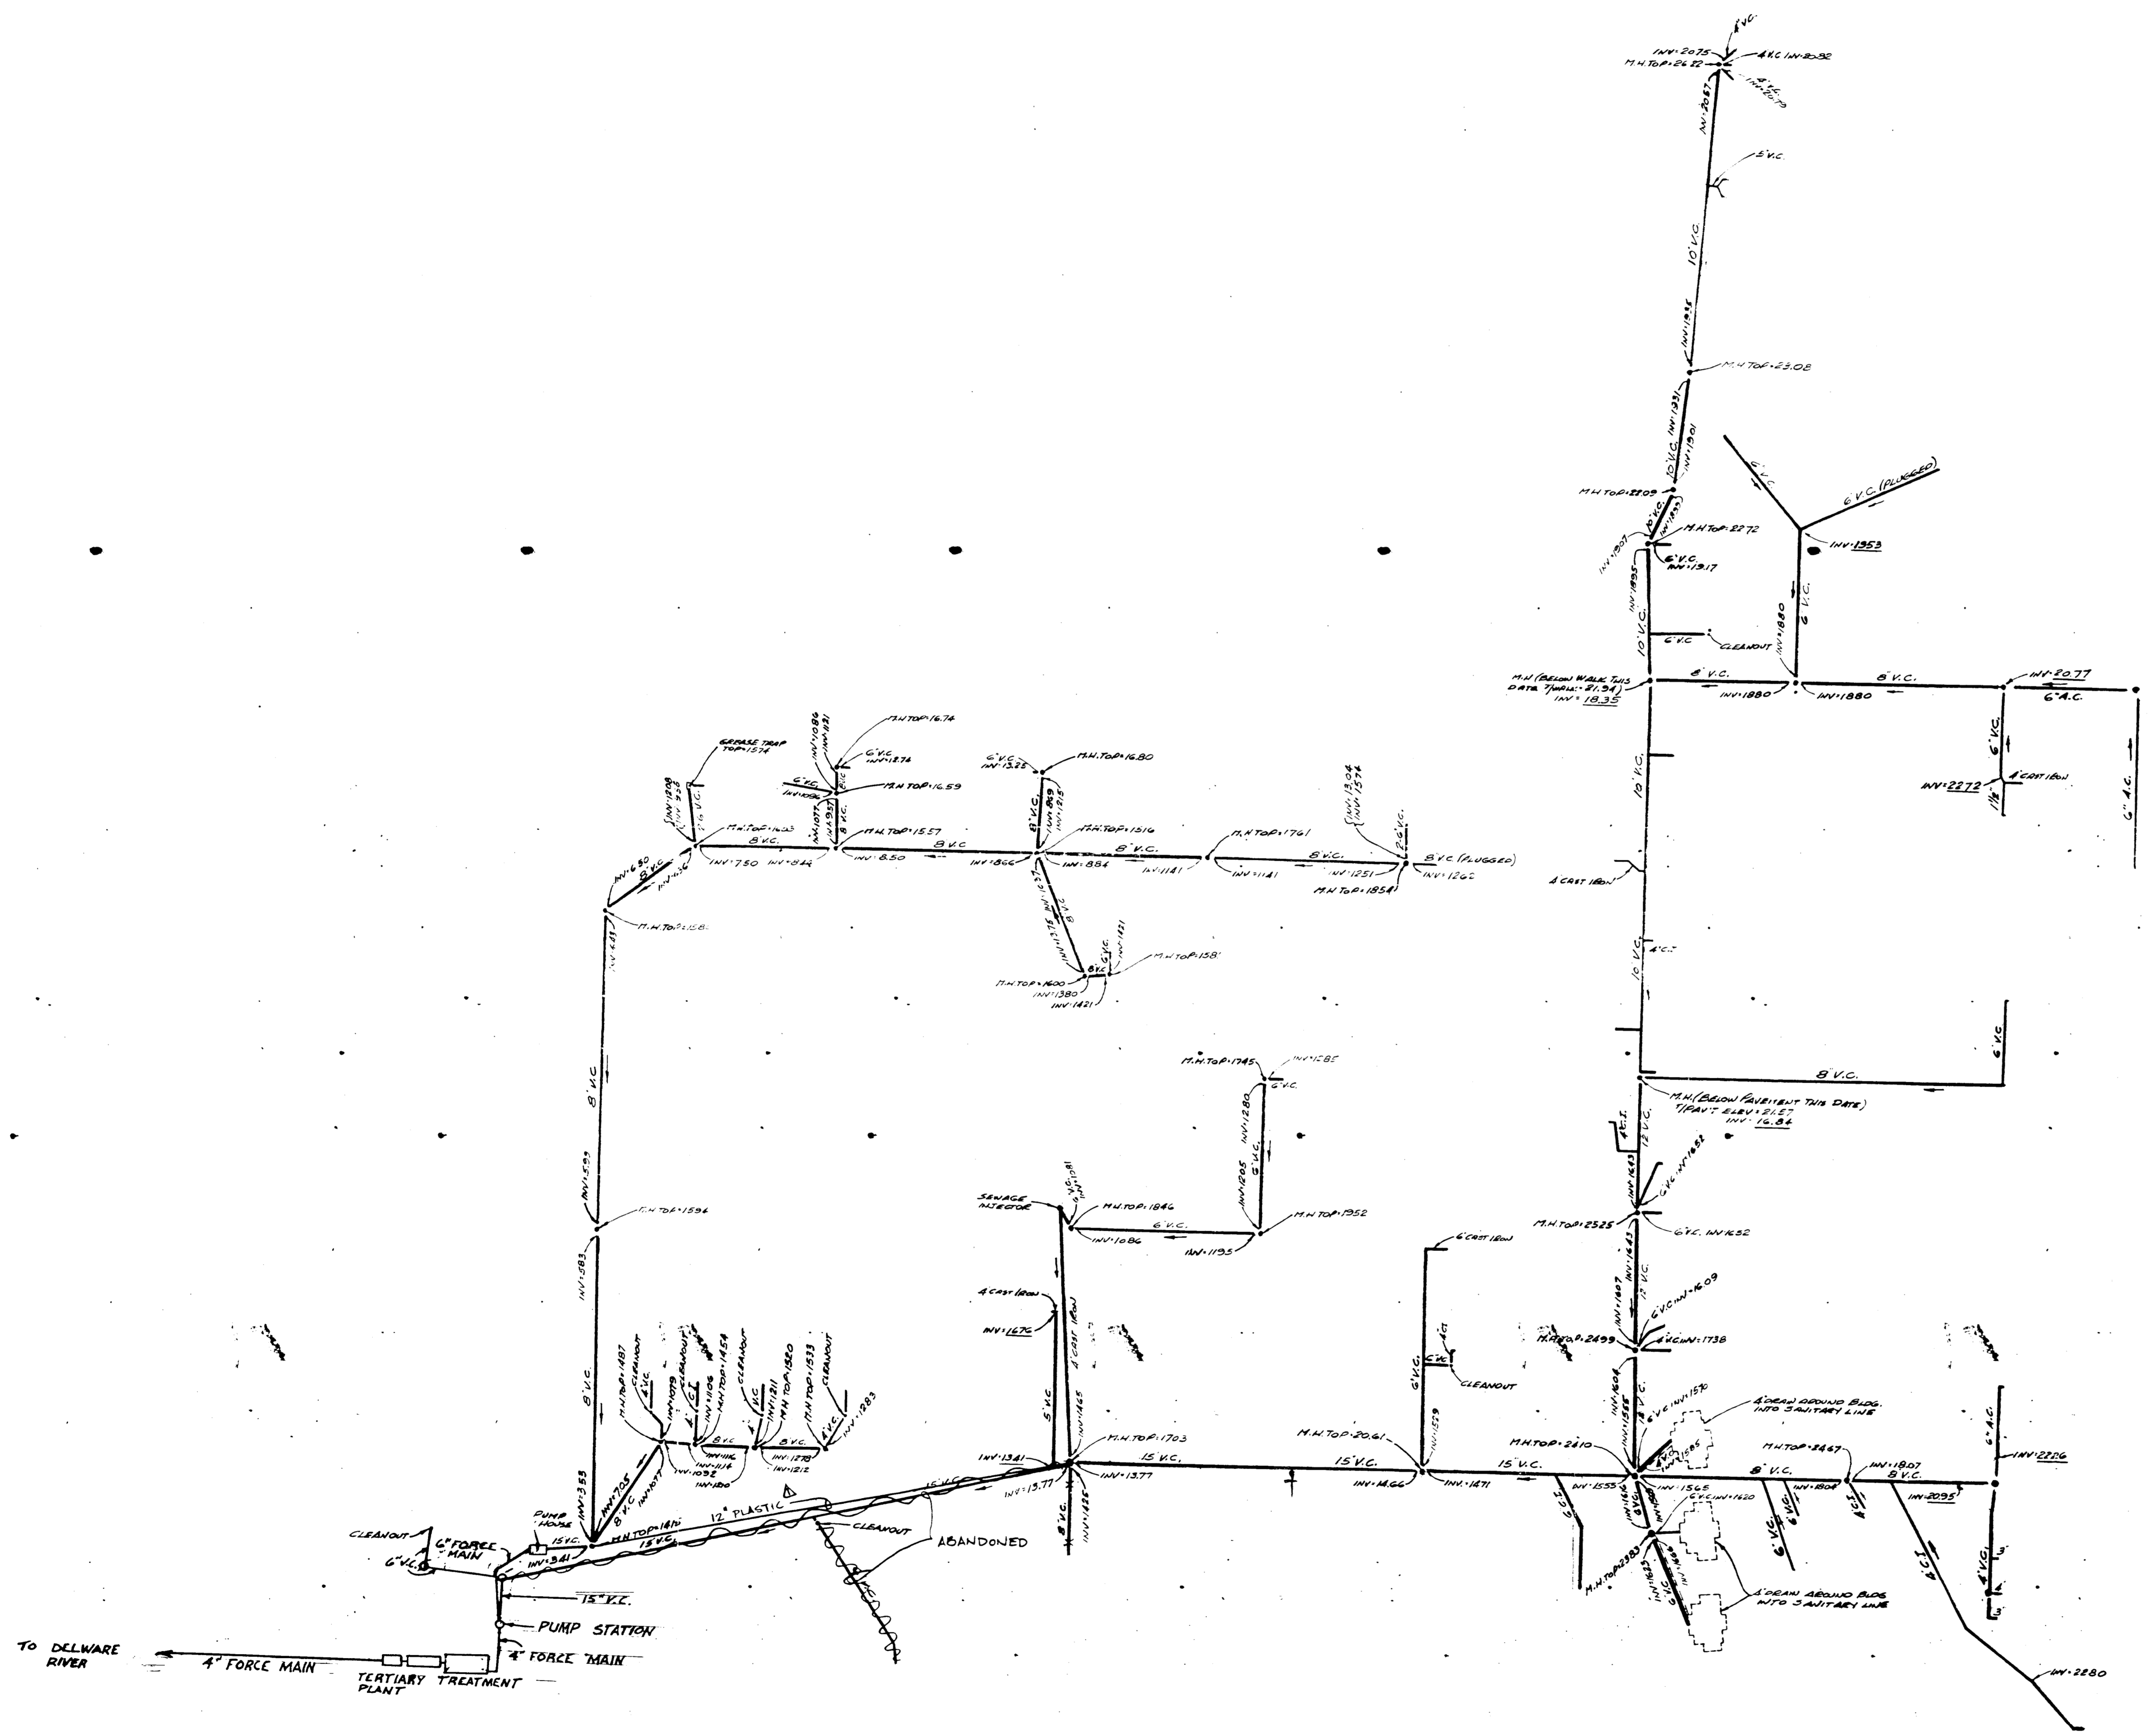

"AS BUILT" SIGNED
 ERNEST A. KAEUBER, RE
 N.J. LIC. NO. 14350

NJ013-0187

REVISION	DATE	DESCRIPTION	BY
10/20/63		SEWER LINE CHANGE	PJB
U. S. ARMY ENGINEER DISTRICT, NEW YORK CORPS OF ENGINEERS NEW YORK 3, NEW YORK			
ARMY AIR DEFENSE PROGRAM BASIC INFORMATION MAPS GENERAL SANITARY SEWER MAP			
DRAWN BY: J.K.P.L.		PHIL. AIR DEF. SITE (PADS) PEDRICKTOWN, NEW JERSEY	
CHECKED BY:		RECOMMENDED BY: <i>[Signature]</i>	
DESIGNED BY: B.J.M.		CHIEF, ENGINEERING DIVISION	
SUBMITTED: M.D. Fialler		ASSISTANT CHIEF, ENGINEERING DIVISION	
REVIEWED: <i>[Signature]</i>		APPROVED: <i>[Signature]</i>	
DATE: 15 MARCH 1962		DRAWING NUMBER: 18-02-02 SHEET 4 OF 10	
FILE NO. 7680-254			

PEDRICKTOWN 7309

M-62-E